2024

# Fairbanks Transit Plan

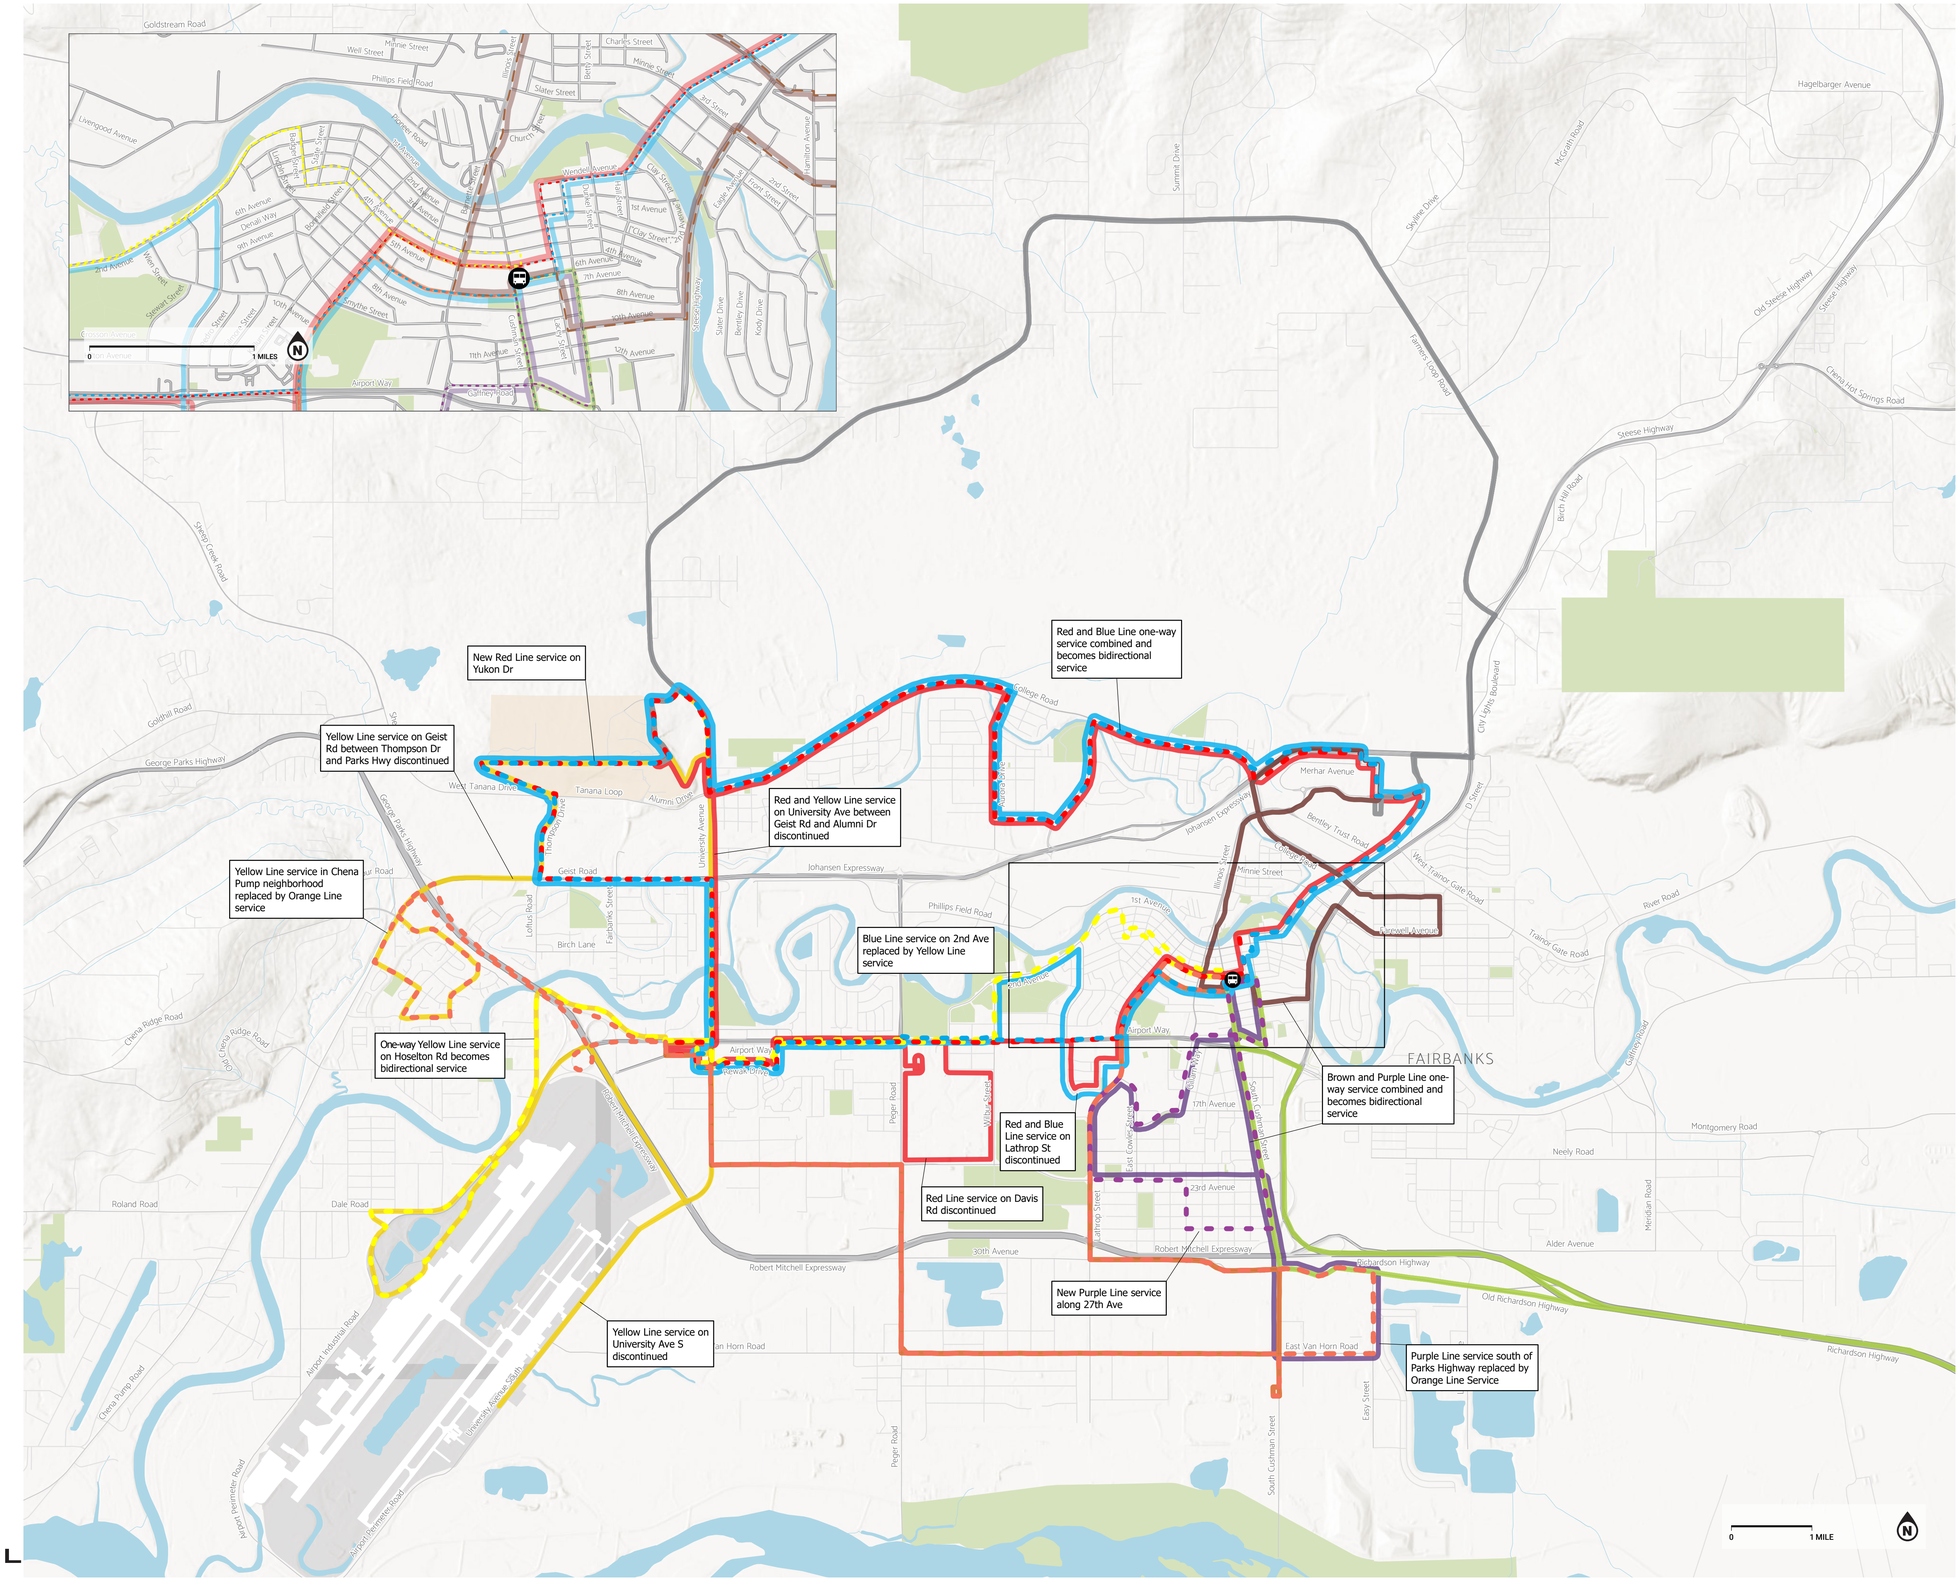


## LEGEND

| Existing Routes | Potential Route Changes |
|---|---|
| Blue Line | Blue |
| Brown Line | Orange |
| Green Line | Purple |
| Grey Line | Red |
| Orange Line | Yellow |
| Purple Line | |
| Red Line | |
| Yellow Line | |

Transit Center